


Notes : -
Record Drawing for information only. Do not scale off this drawing. Dimensions of all spaces, including heights and structure must be verified by site measurement. Layout, routes and types of existing services/utilities indicated on this drawing have been collated from historical information and limited site surveys. Hamilton Architects do not accept responsibility for accuracy or completeness of information indicated on this drawing.

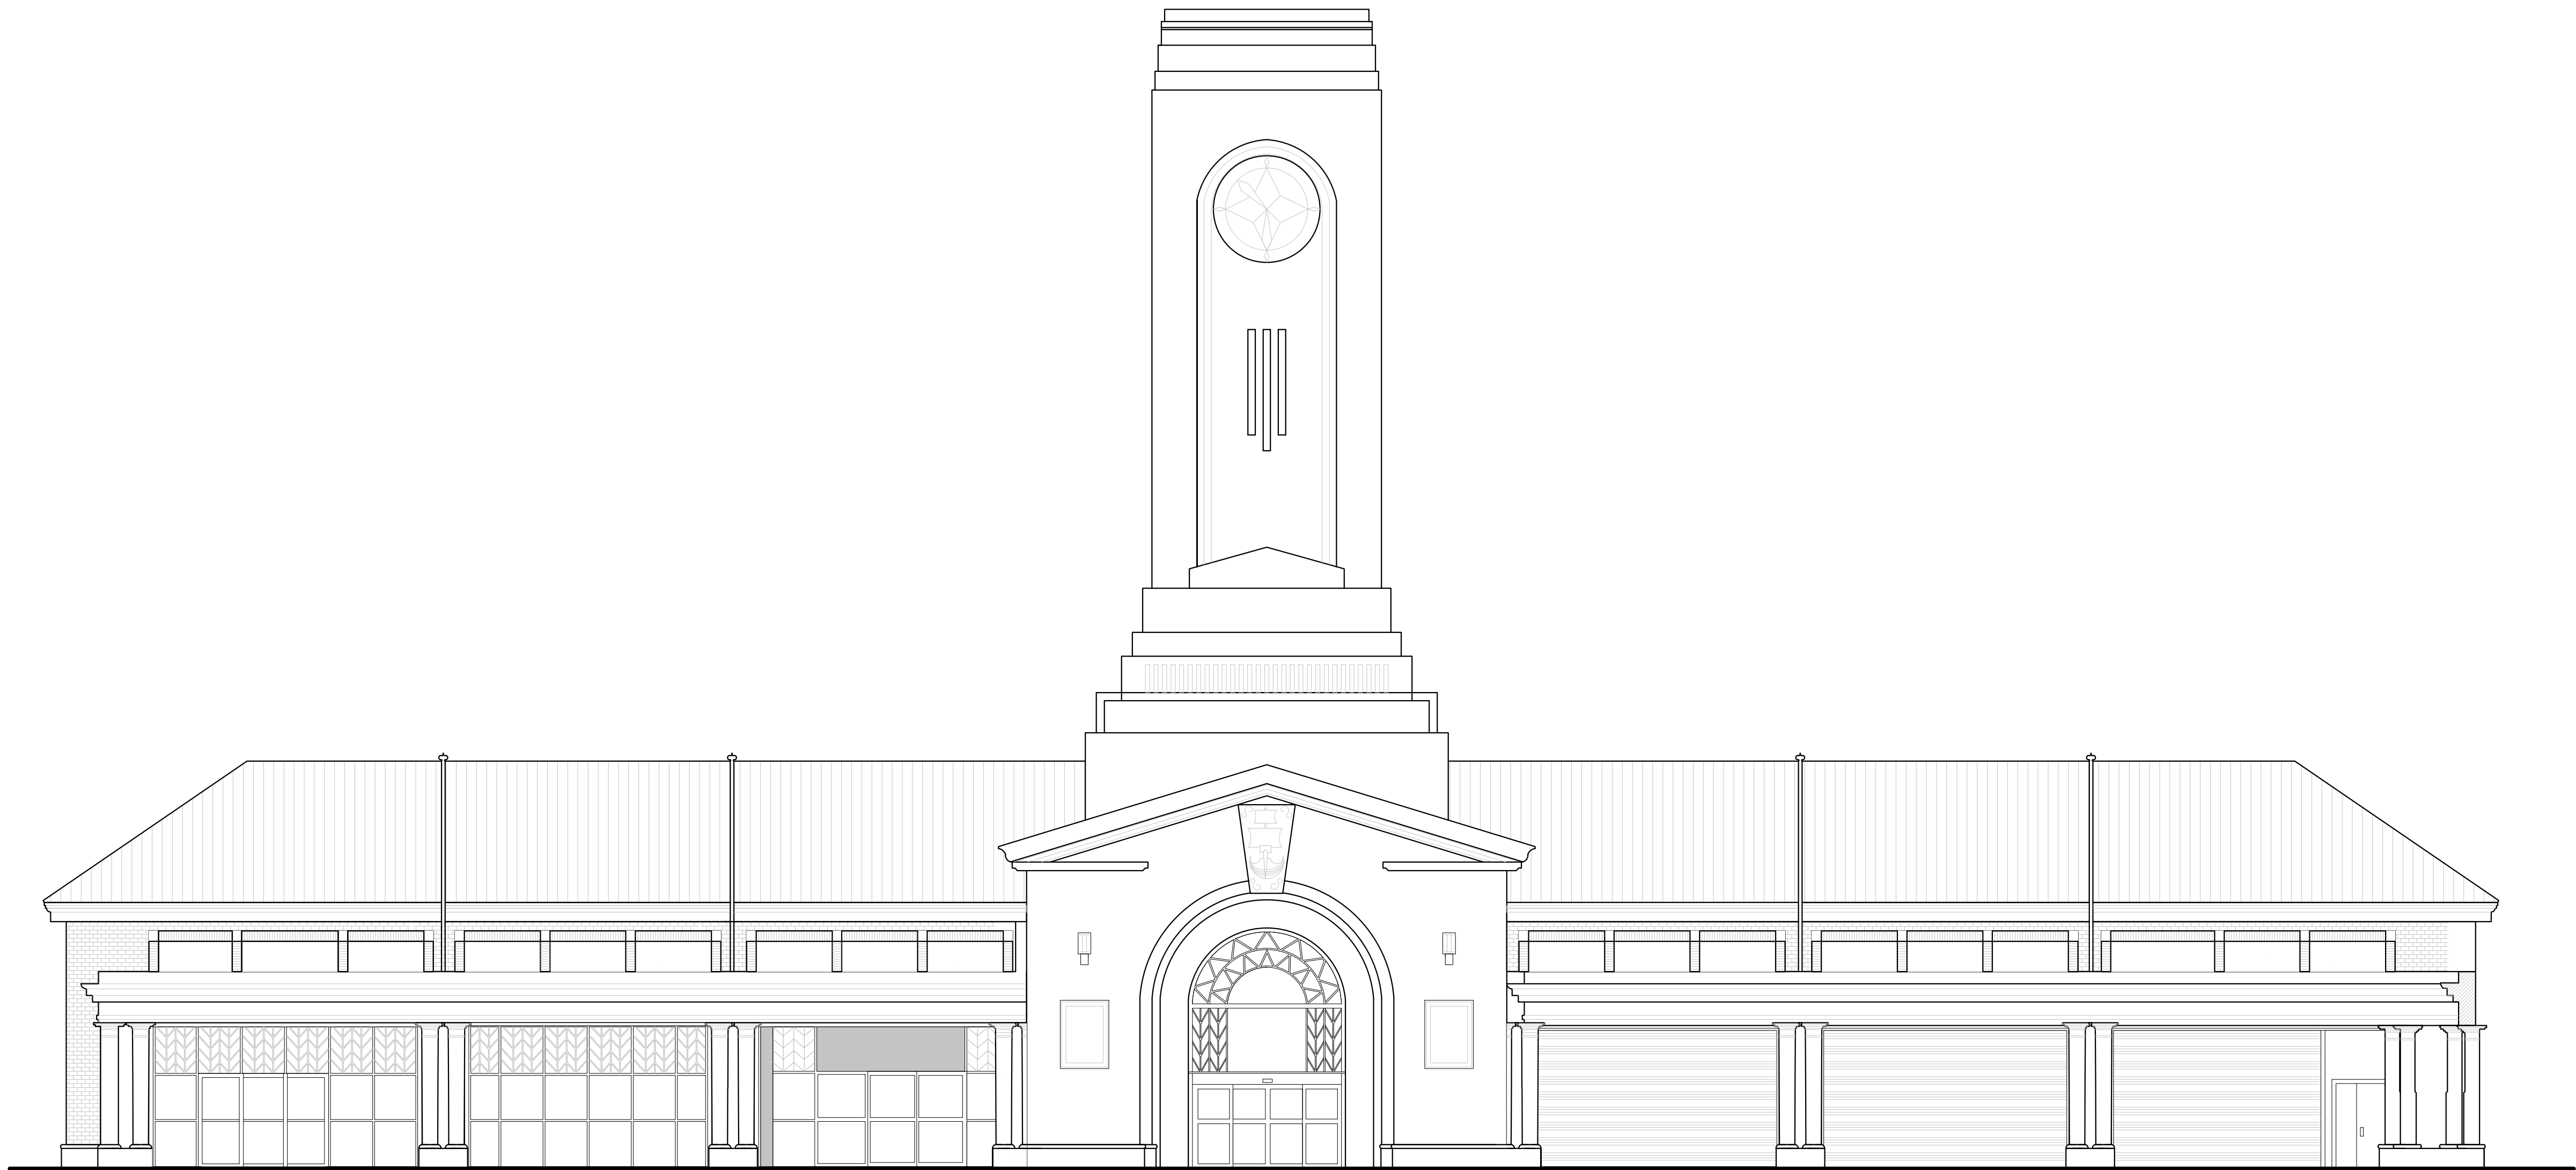

01 Existing West Elevation 1:100

| Rev | Date | Description | By |
|-----|------|-------------|----|
| | | | |

revisions

TENDER



Chartered Architects

HAMILTON HOUSE
3 JOY STREET
BELFAST
BT2 8LE

t: +44 (0) 28 9033 4250
f: +44 (0) 28 9023 3249
e: belfast@hamiltonarchitects.co.uk

| |
|--------------|
| client |
| Merseytravel |

| | |
|------------------------|------|
| project | 1496 |
| Seacombe Refurbishment | |

| | | | |
|-------------------------|--------------------|-------------|---------------|
| drawing (01) 10 | revision | | |
| Existing West Elevation | | | |
| scale 1:100/A1 | date 09.03.2015 | drawn MW | checked MH |

Also at: 20 Queen Street, Derry BT48 7EQ
t: +44 (0) 28 7137 0017 f: +44 (0) 28 7137 4794
e: derry@hamiltonarchitects.com

© Copyright Hamilton Architects

DO NOT SCALE FROM THIS DRAWING
All dimensions are in millimetres unless otherwise indicated