


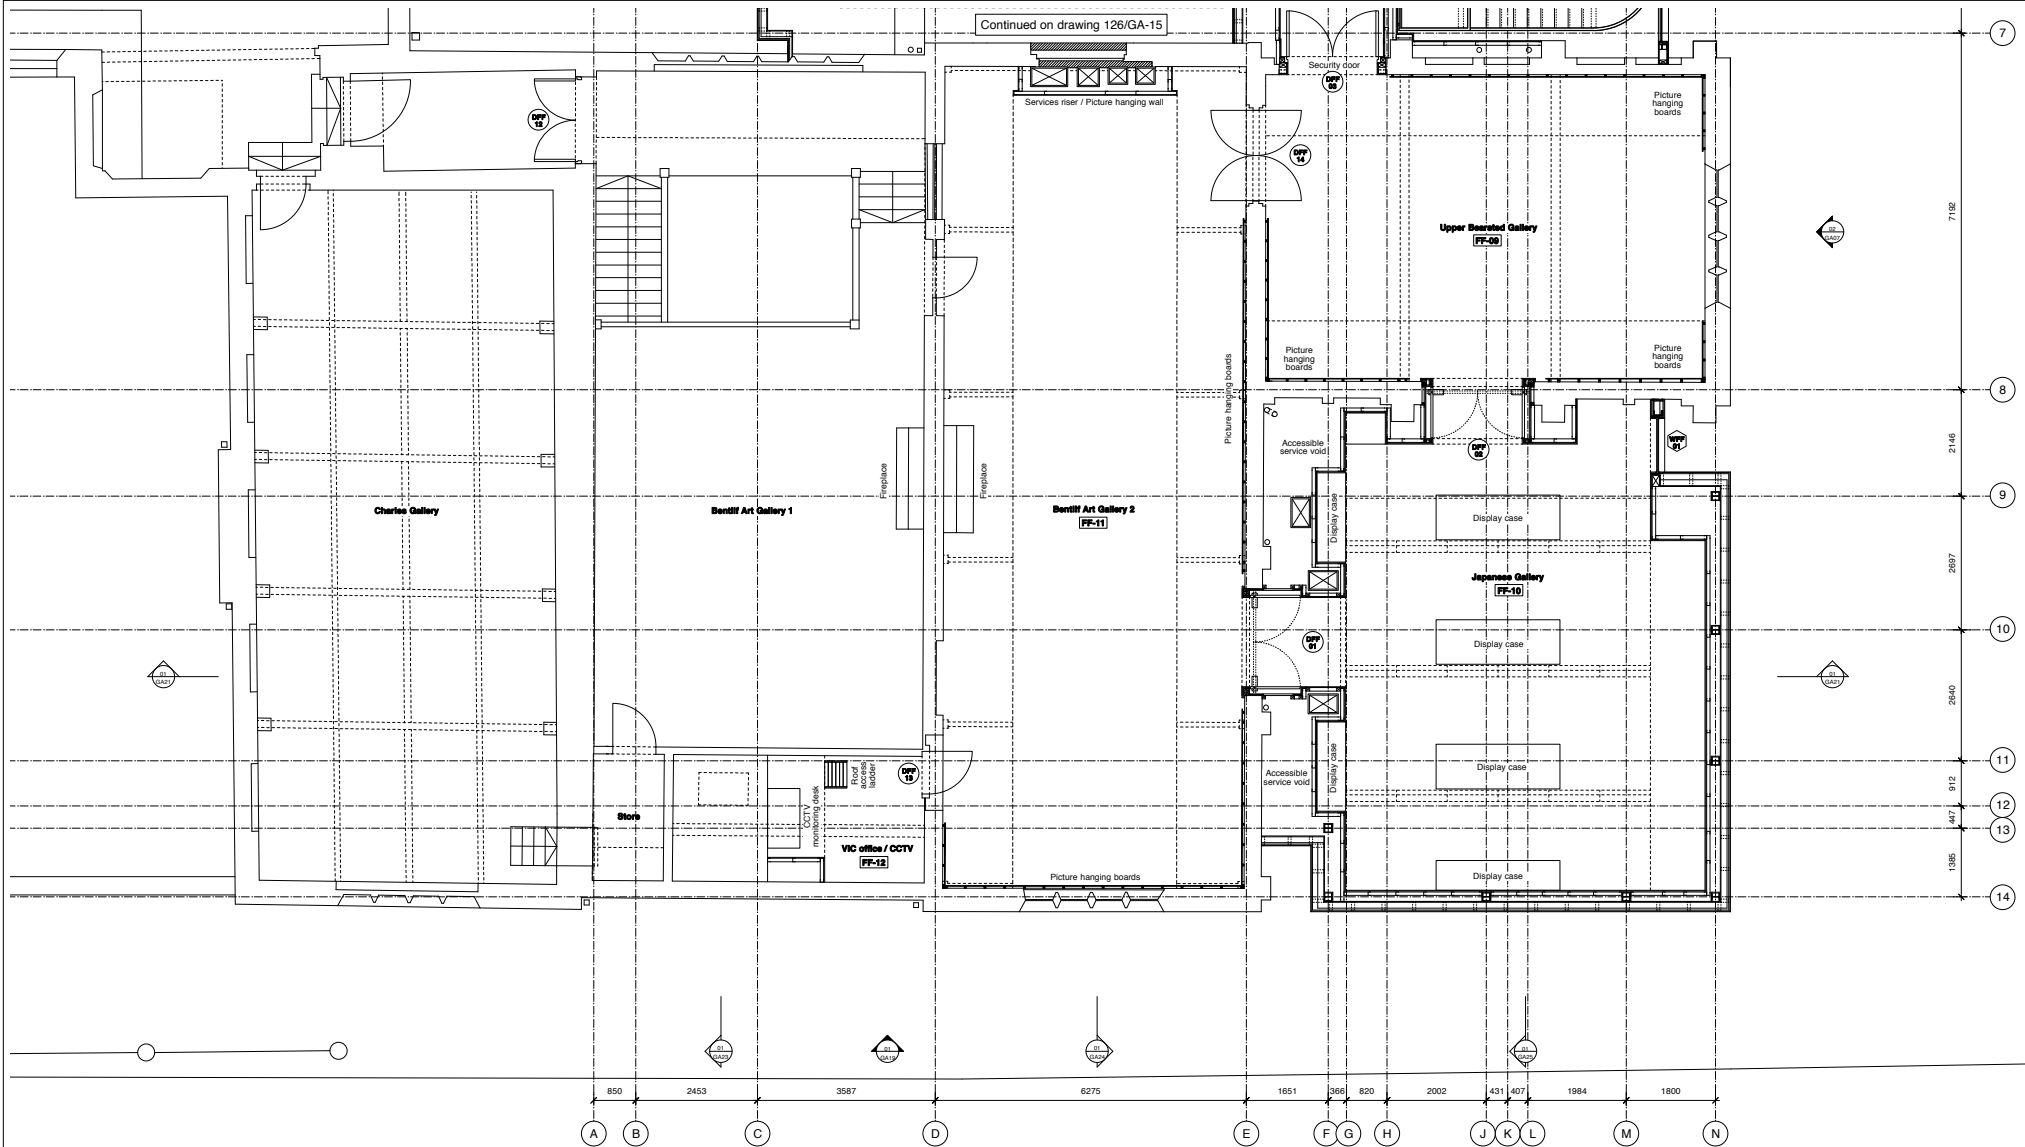

Do not scale drawings
All dimensions are in millimetres unless stated otherwise
Use figured dimensions only and report any discrepancies in writing to the architect

	Elevation reference
	Section reference
	Door number
	Window number
	Below ground
	Concrete blockwork/brickwork

Key Plan



AB	As Built issue	GR	10/10/11
C2	General update	NB	24/01/11
C1	Construction issue	GR	10/09/10
PC1	Planning Conditions response issue	GR	10/01/10
T5	Revised Tender issue	GR	14/09/09
T4	Revised Tender issue	GR	30/07/09
T3	Revised Tender issue	GR	28/11/08
T2	Tender issue	GR	06/05/08
T1	Preliminary Tender issue	GR	12/05/08
E1	Stage II issue	MM	26/10/07
For coordination only	MM	22/10/07	
Rev	Description	Drawn	Date

Maidstone Museum & Bentlif Art Gallery
East Wing Development

Proposed First Floor Plan- Zone 1
Status: As Built
Scale 1:50

November 2008

Draw N° 126/GA-14
Drawn by MM
Checked by
Rev AB
Size A1

HUGH BROUGHTON ARCHITECTS

41a Beaver Lane, London W6 9BL

T 020 8735 9959 F 020 8563 3891 E info@hbaarchitects.co.uk

© Hugh Broughton Architects