




VISUAL SCALE 1:100

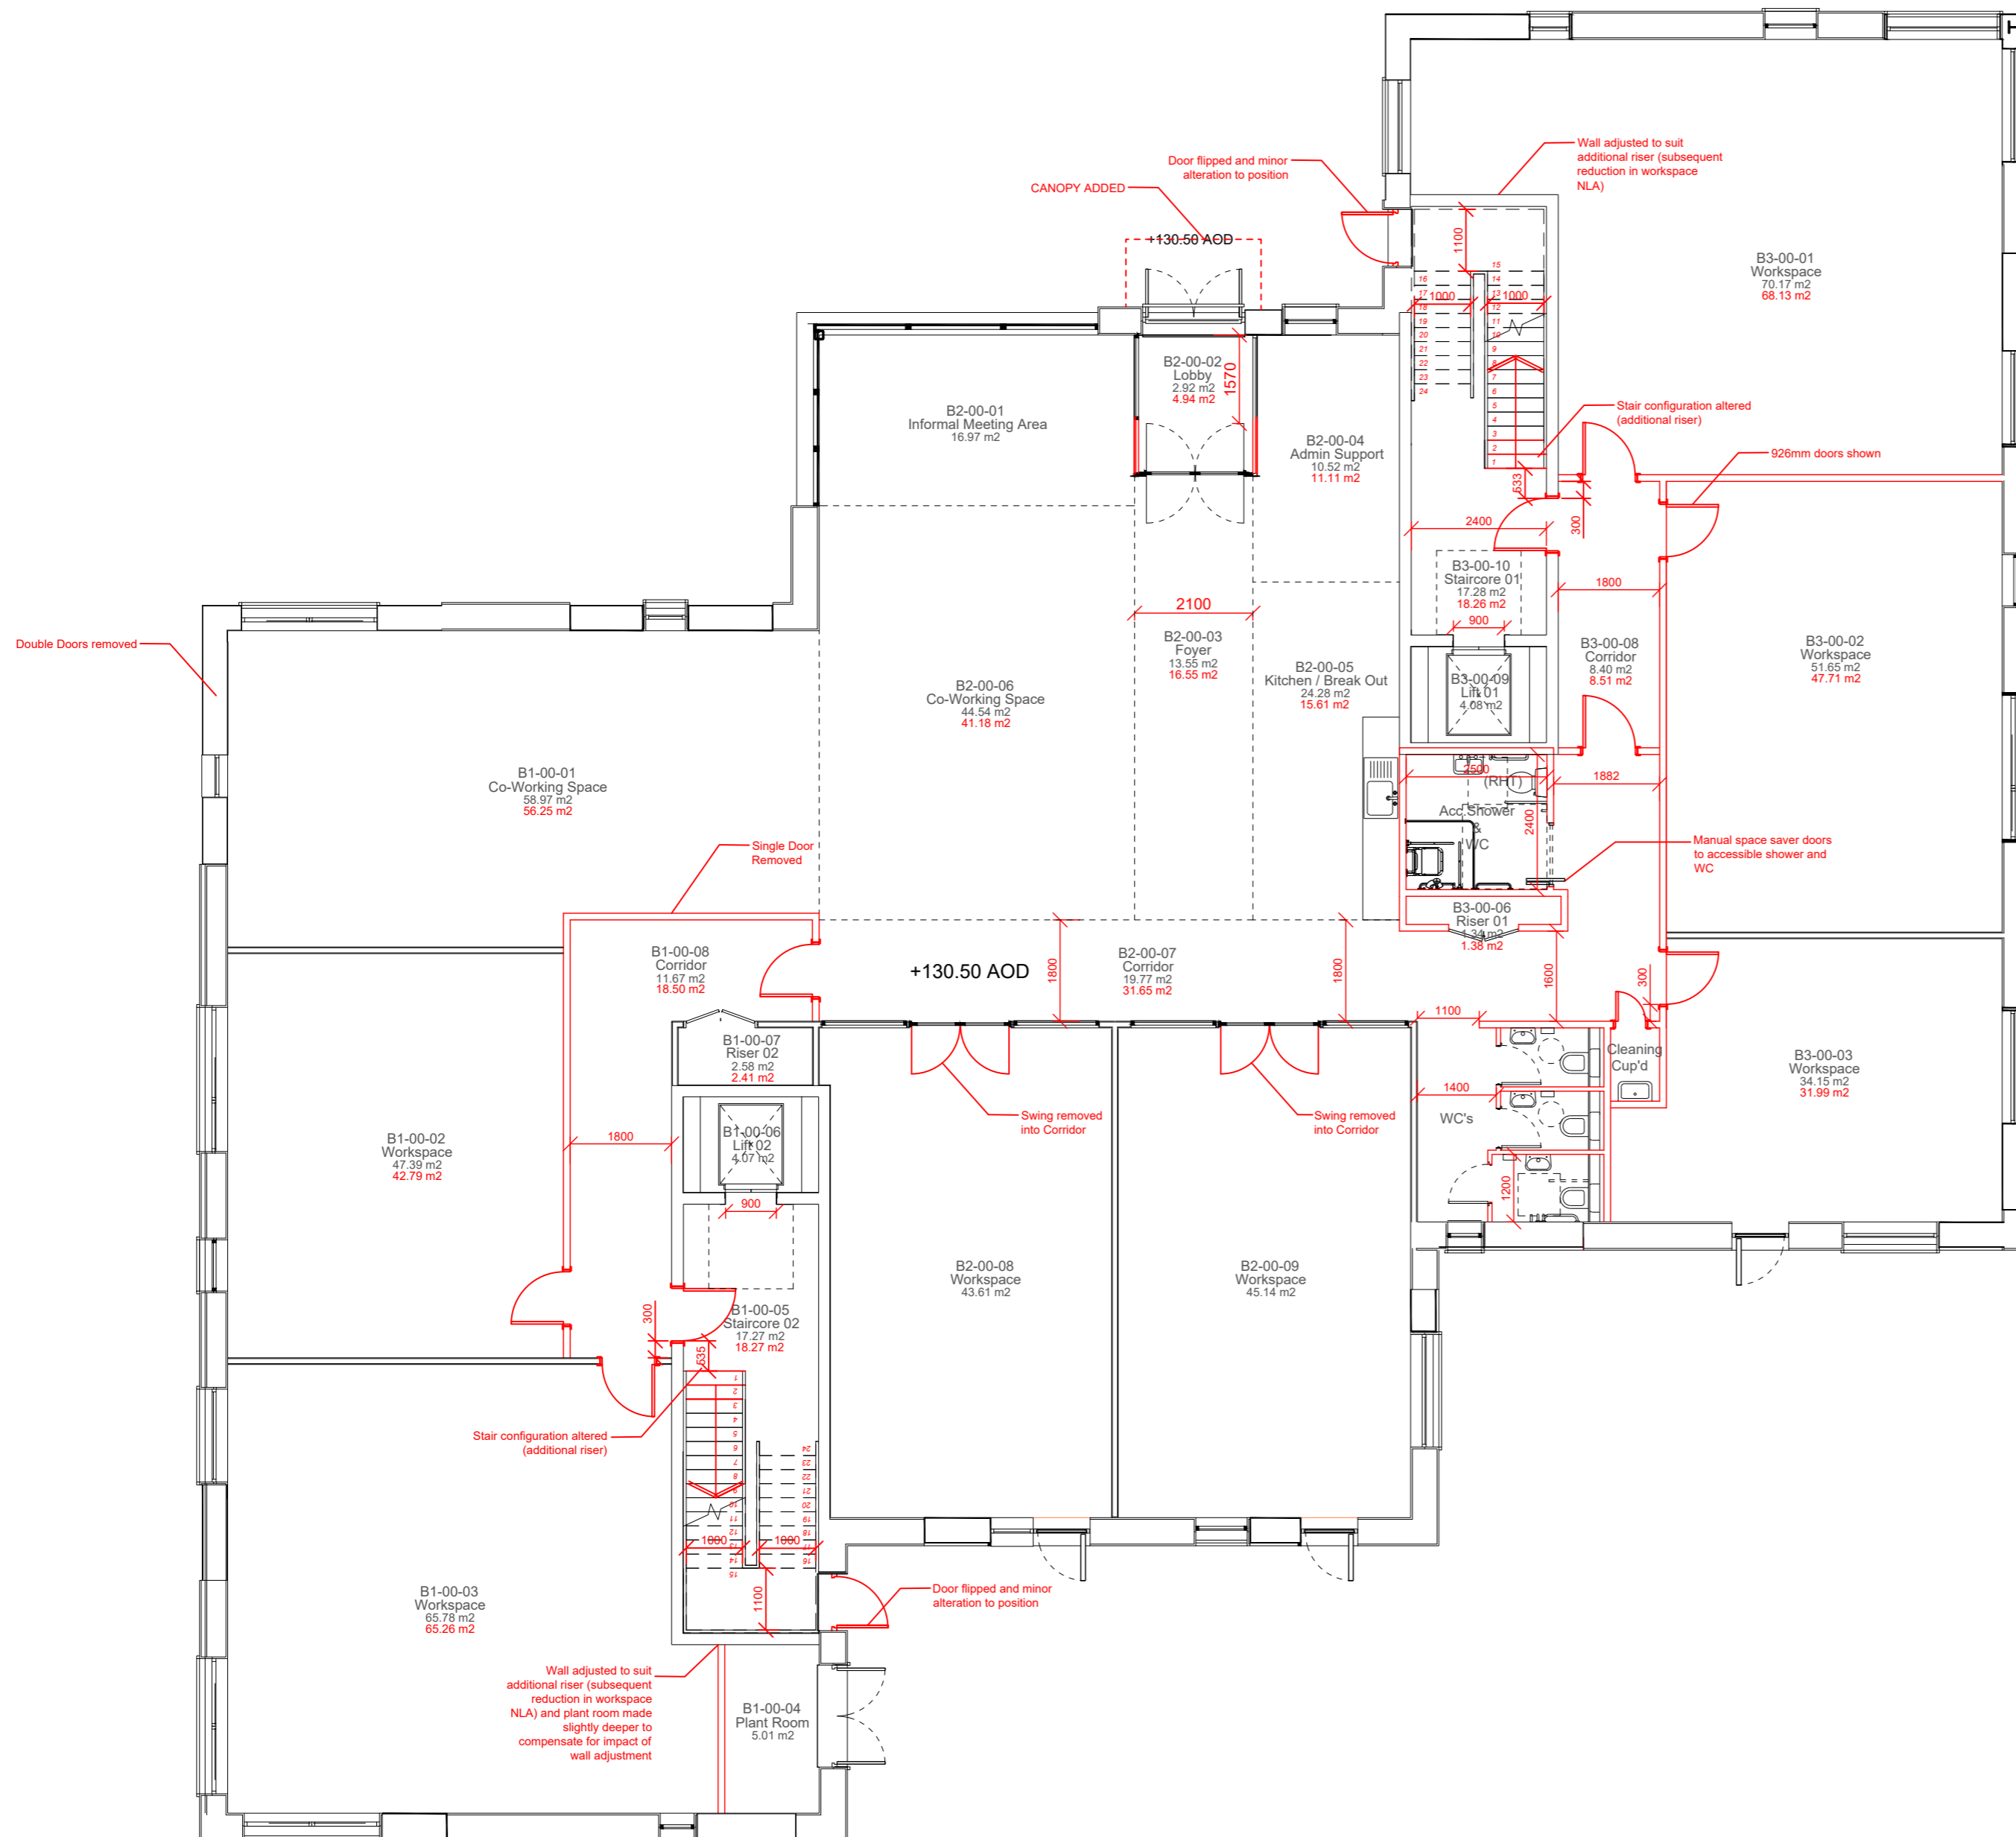

NOTE:
 REVISED AREA FIGURES ARE INDICATED IN RED
 BELOW THE ORIGINAL FIGURES, FOR EASE OF
 COMPARISON
 FINAL COLUMN LOCATIONS TBC

REV	DATE	COMMENTS	AUTHOR / CHECKED
E	26.11.20	Lift door openings increased to 900mm	KS / GP
D	18.11.20	Door from B1-00-01 (into corridor) removed	KS / GP
C	11.11.20	Combined accessible shower/wc reintroduced. Riser and corridor reconfigured. Kitchen/breakout zone enlarged. Updates to NLA's.	KS / GP
B	05.11.20	Alterations to stair cores and egress doors, NLA's, ambulant WC	KS / GP
A	29.10.20	Minor internal alterations, updates to floor areas in rooms: B2-00-15 & B2-00-06.	KS / GP

PROJECT TITLE
LISKEARD CATTLE MARKET WORK HUB

DETAIL
GROUND FLOOR INTERNAL REVISIONS

DRAWING NUMBER
 (PROJECT-ORIGINATOR-ZONE-LEVEL-TYPE-ROLE-NUMBER)
LCM -LHC - 00 - 00 - DR - AR - 02.00

STATUS	STATUS DESCRIPTION	
S3	FOR DISCUSSION	
REVISION	DATE	SCALE
E	22/10/20	1:100 @A2
CONTRACTORS MUST CHECK ALL DIMENSIONS ON SITE - ONLY FIGURED DIMENSIONS ARE TO BE WORKED FROM - DISCREPANCIES MUST BE REPORTED TO THE ARCHITECT BEFORE PROCEEDING © THIS DRAWING IS COPYRIGHT		LHC PROJECT NUMBER 19155

EXETER
 01392 444334
 PLYMOUTH
 01752 668368
 ST AUSTELL
 01726 213435
 lhc.net