


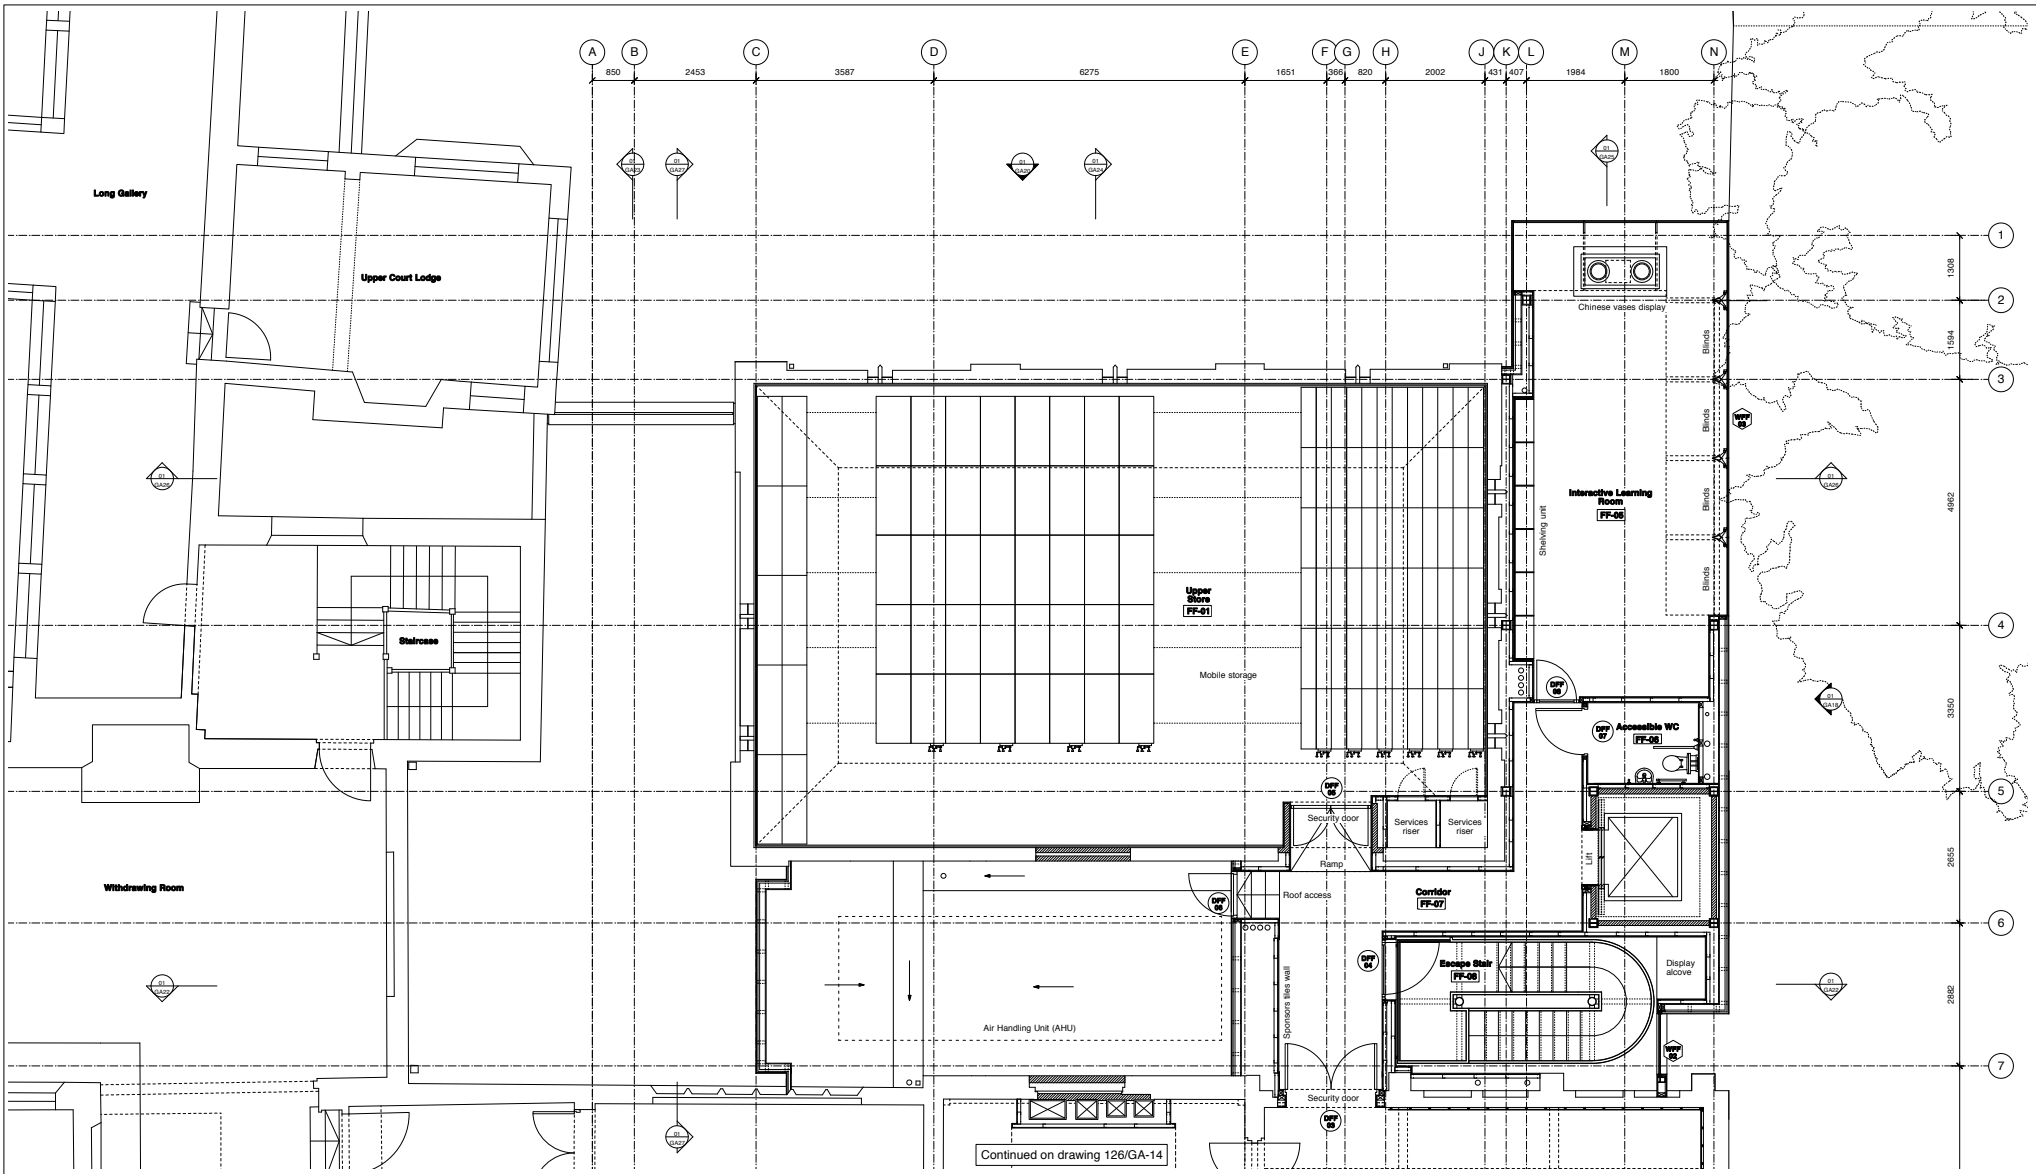

Do not scale drawings

All dimensions are in millimetres unless stated otherwise

Use figured dimensions only and report any discrepancies in writing to the architect

**Key**

- Elevation reference
- Section reference
- Door number
- Window number
- Below ground
- Concrete blockwork/brickwork

**Key Plan**

|     |                                    |       |          |
|-----|------------------------------------|-------|----------|
| AB  | As Built Issue                     | GR    | 10/10/11 |
| C2  | General update                     | HB    | 24/01/11 |
| C3  | Construction issue                 | GR    | 12/03/10 |
| PC1 | Planning conditions response issue | GR    | 15/01/10 |
| T5  | Revised Tender Issue               | GR    | 14/09/09 |
| T4  | Tender Issue                       | AW    | 30/07/09 |
| T3  | Tender Issue                       | GR    | 28/11/08 |
| T2  | Tender Issue                       | GR    | 06/06/08 |
| T1  | Preliminary Tender Issue           | GR    | 12/05/08 |
| E1  | Stage E Issue                      | MM    | 26/10/07 |
| .   | For coordination only              | MM    | 22/10/07 |
| Rev | Description                        | Drawn | Date     |

Maidstone Museum & Bentlif Art Gallery  
**East Wing Development**

Proposed First Floor Plan - Zone 2  
Status: As Built  
Scale 1:50

November 2008

Draw N° 126/GA-15  
Drawn by MM  
Checked by

Rev AB  
Size A1

**HUGHBROUGHTONARCHITECTS**  
41a Beaver Lane, London W6 9EL  
T 020 8735 9959 F 020 8563 3891 E info@hughbroughtonarchitects.co.uk

© Hugh Broughton Architects