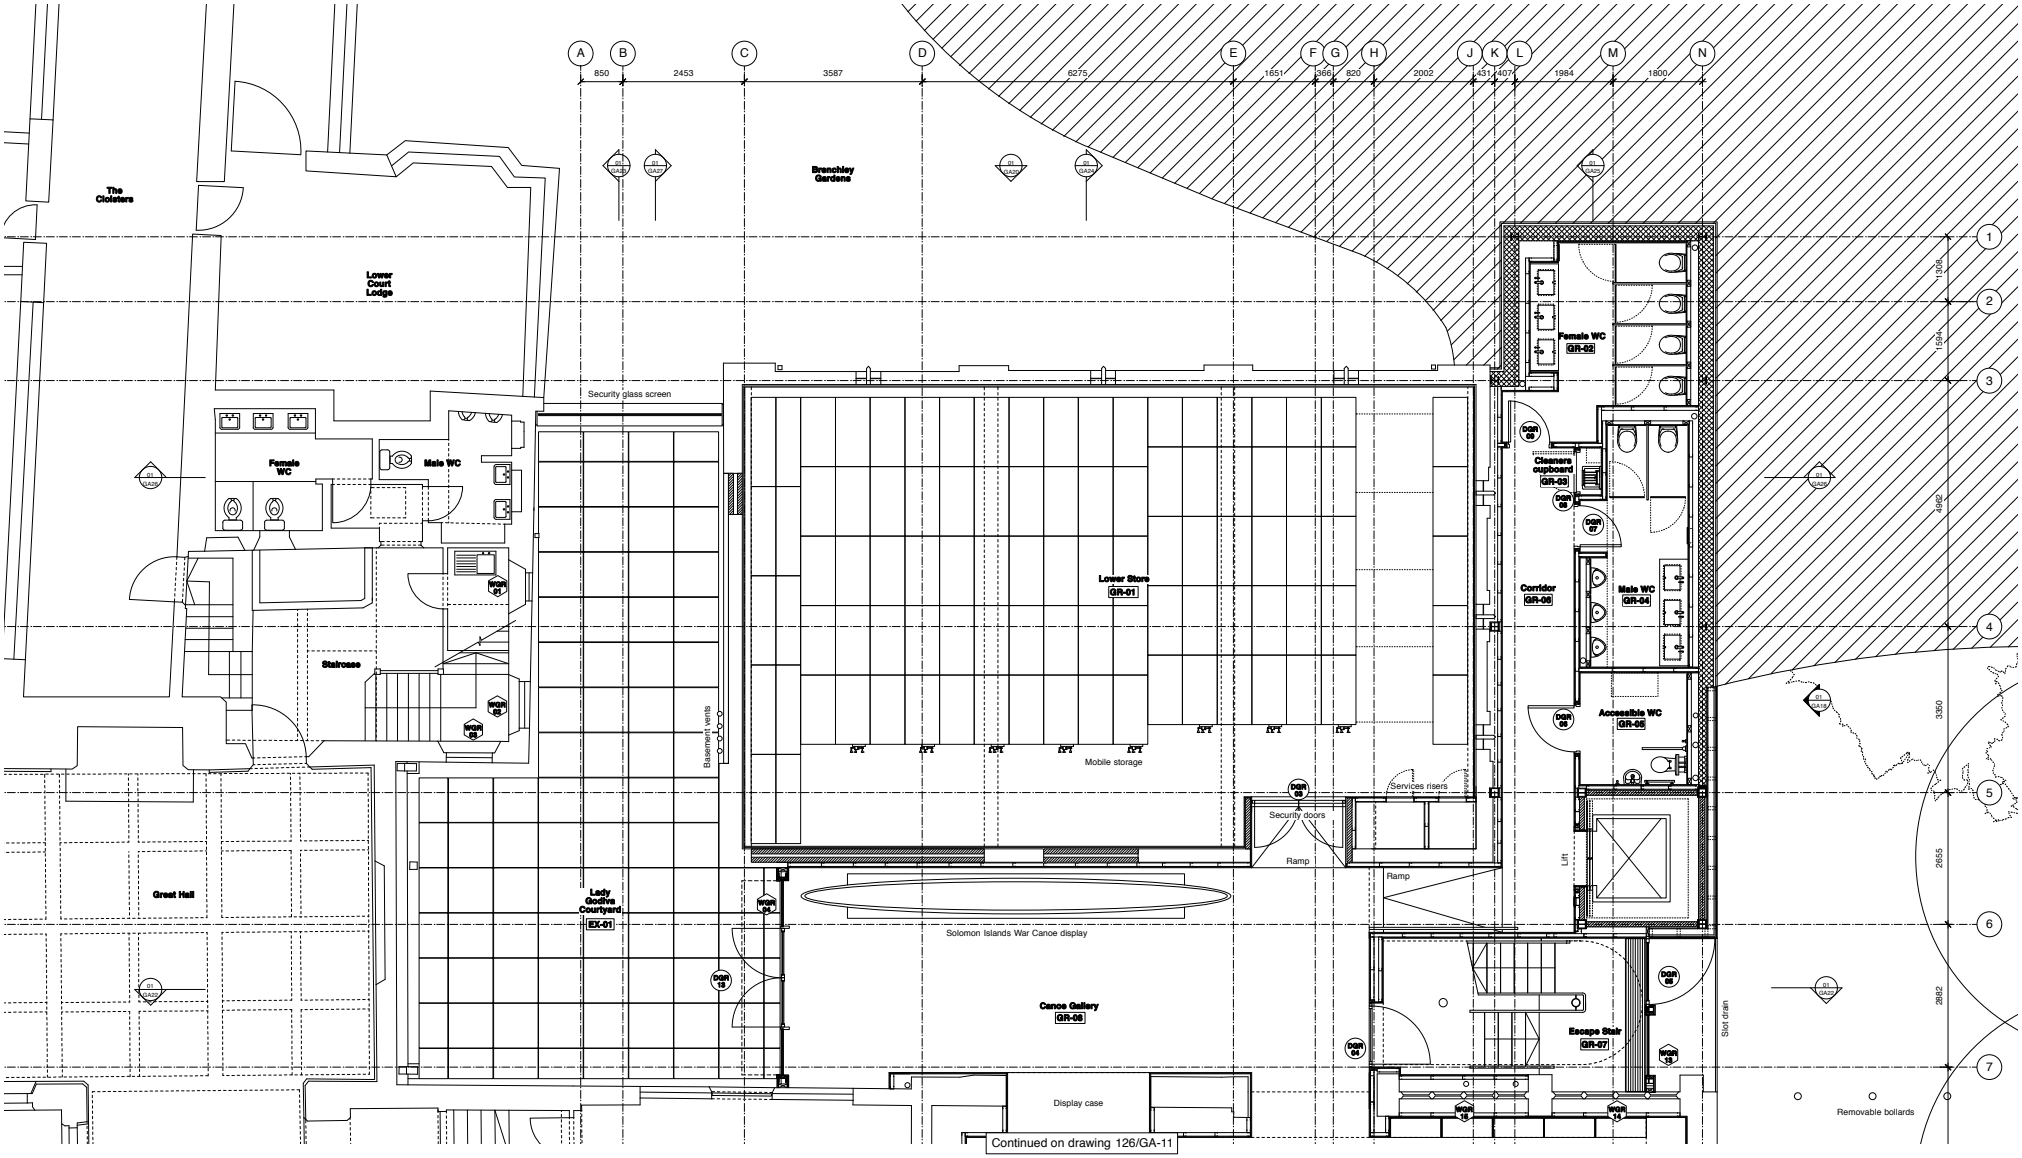

Do not scale drawings

All dimensions are in millimetres unless stated otherwise

Use figured dimensions only and report any discrepancies in writing to the architect

Key

- Elevation reference
- Section reference
- Door number
- Window number
- Below ground
- Concrete blockwork
- Reinforced concrete

Key Plan

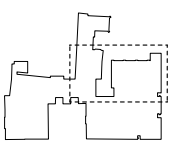

Rev	Description	Drawn	Date
AB	As built issue	GR	10/10/11
C3	Finish to courtyard retaining wall changed	GR	25/02/11
C2	General update	NB	24/01/11
C1	Construction issue	GR	12/03/10
PC1	Planning Conditions response issue	GR	15/01/10
T5	Revised Tender Issue	GR	14/09/09
T4	Revised Tender Issue	AW	30/07/09
T3	Revised Tender Issue	GR	28/11/08
T2	Tender Issue	GR	06/06/08
T1	Preliminary Tender Issue	GR	12/05/08
E1	Stage E Issue	MM	26/10/07
-	For coordination only	MM	22/10/07

Maidstone Museum & Bentlif Art Gallery
East Wing Development

Proposed Ground Floor Plan - Zone 2
Status: As built
Scale 1:50

November 2008

Draw N° 126/GA-12 | Rev AB
Drawn by MM | Checked by | Size A1

HUGH**BROUGHTON**ARCHITECTS
41a Beavor Lane, London W6 9BL
T 020 8735 9959 F 020 8563 3891 E info@hbarchitects.co.uk

© Hugh Broughton Architects